SUITE: 400 RSF: 13,109 1212 S FLOWER

AS-BUILT CONFIGURATION

RECEPTION..... 1

OFFICES..... 8

CONFERENCE ROOMS..... 4

OPEN WORK AREA..... +/- 78

KITCHEN..... 1

Not to scale, furniture and appliances not included

KEY PLAN

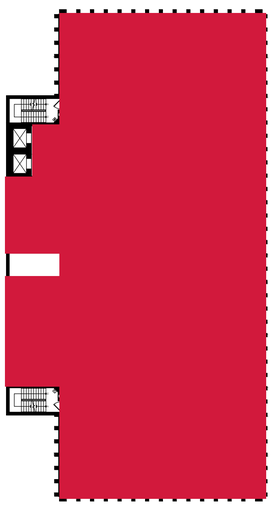

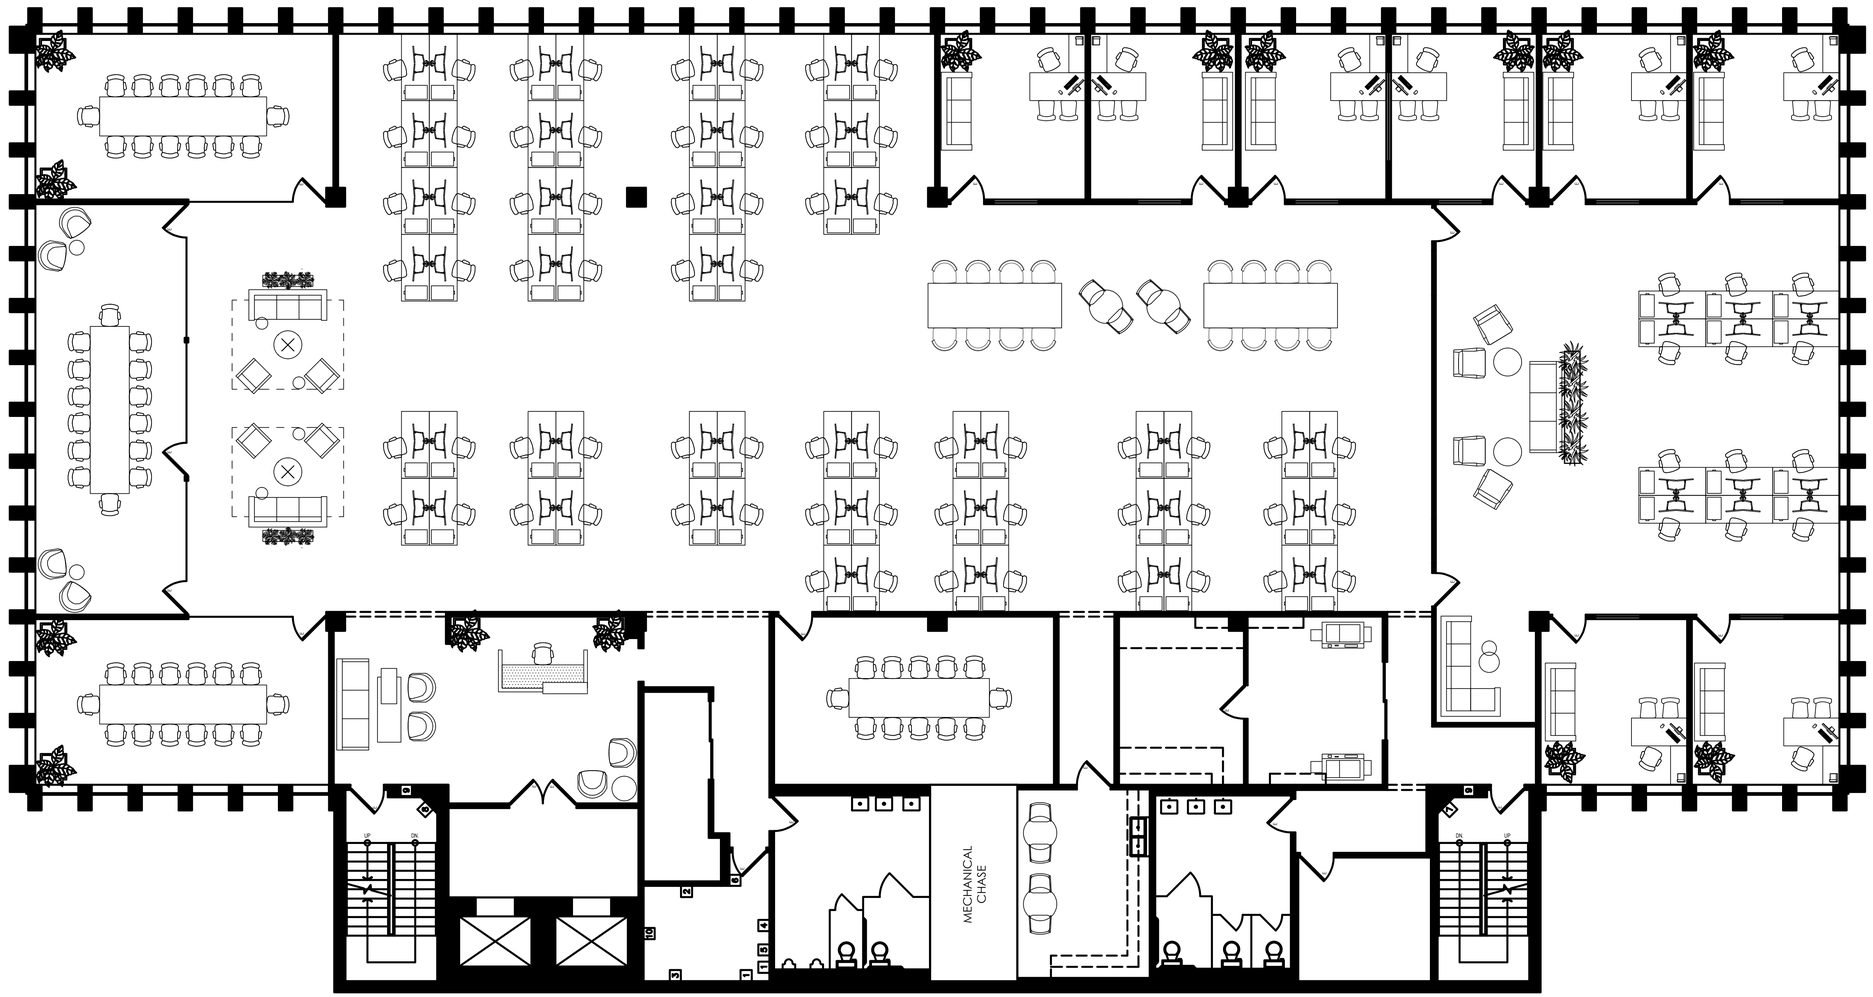

PLEASE CONTACT:
USALEASING@ONNI.COM
(213) 629 - 2041